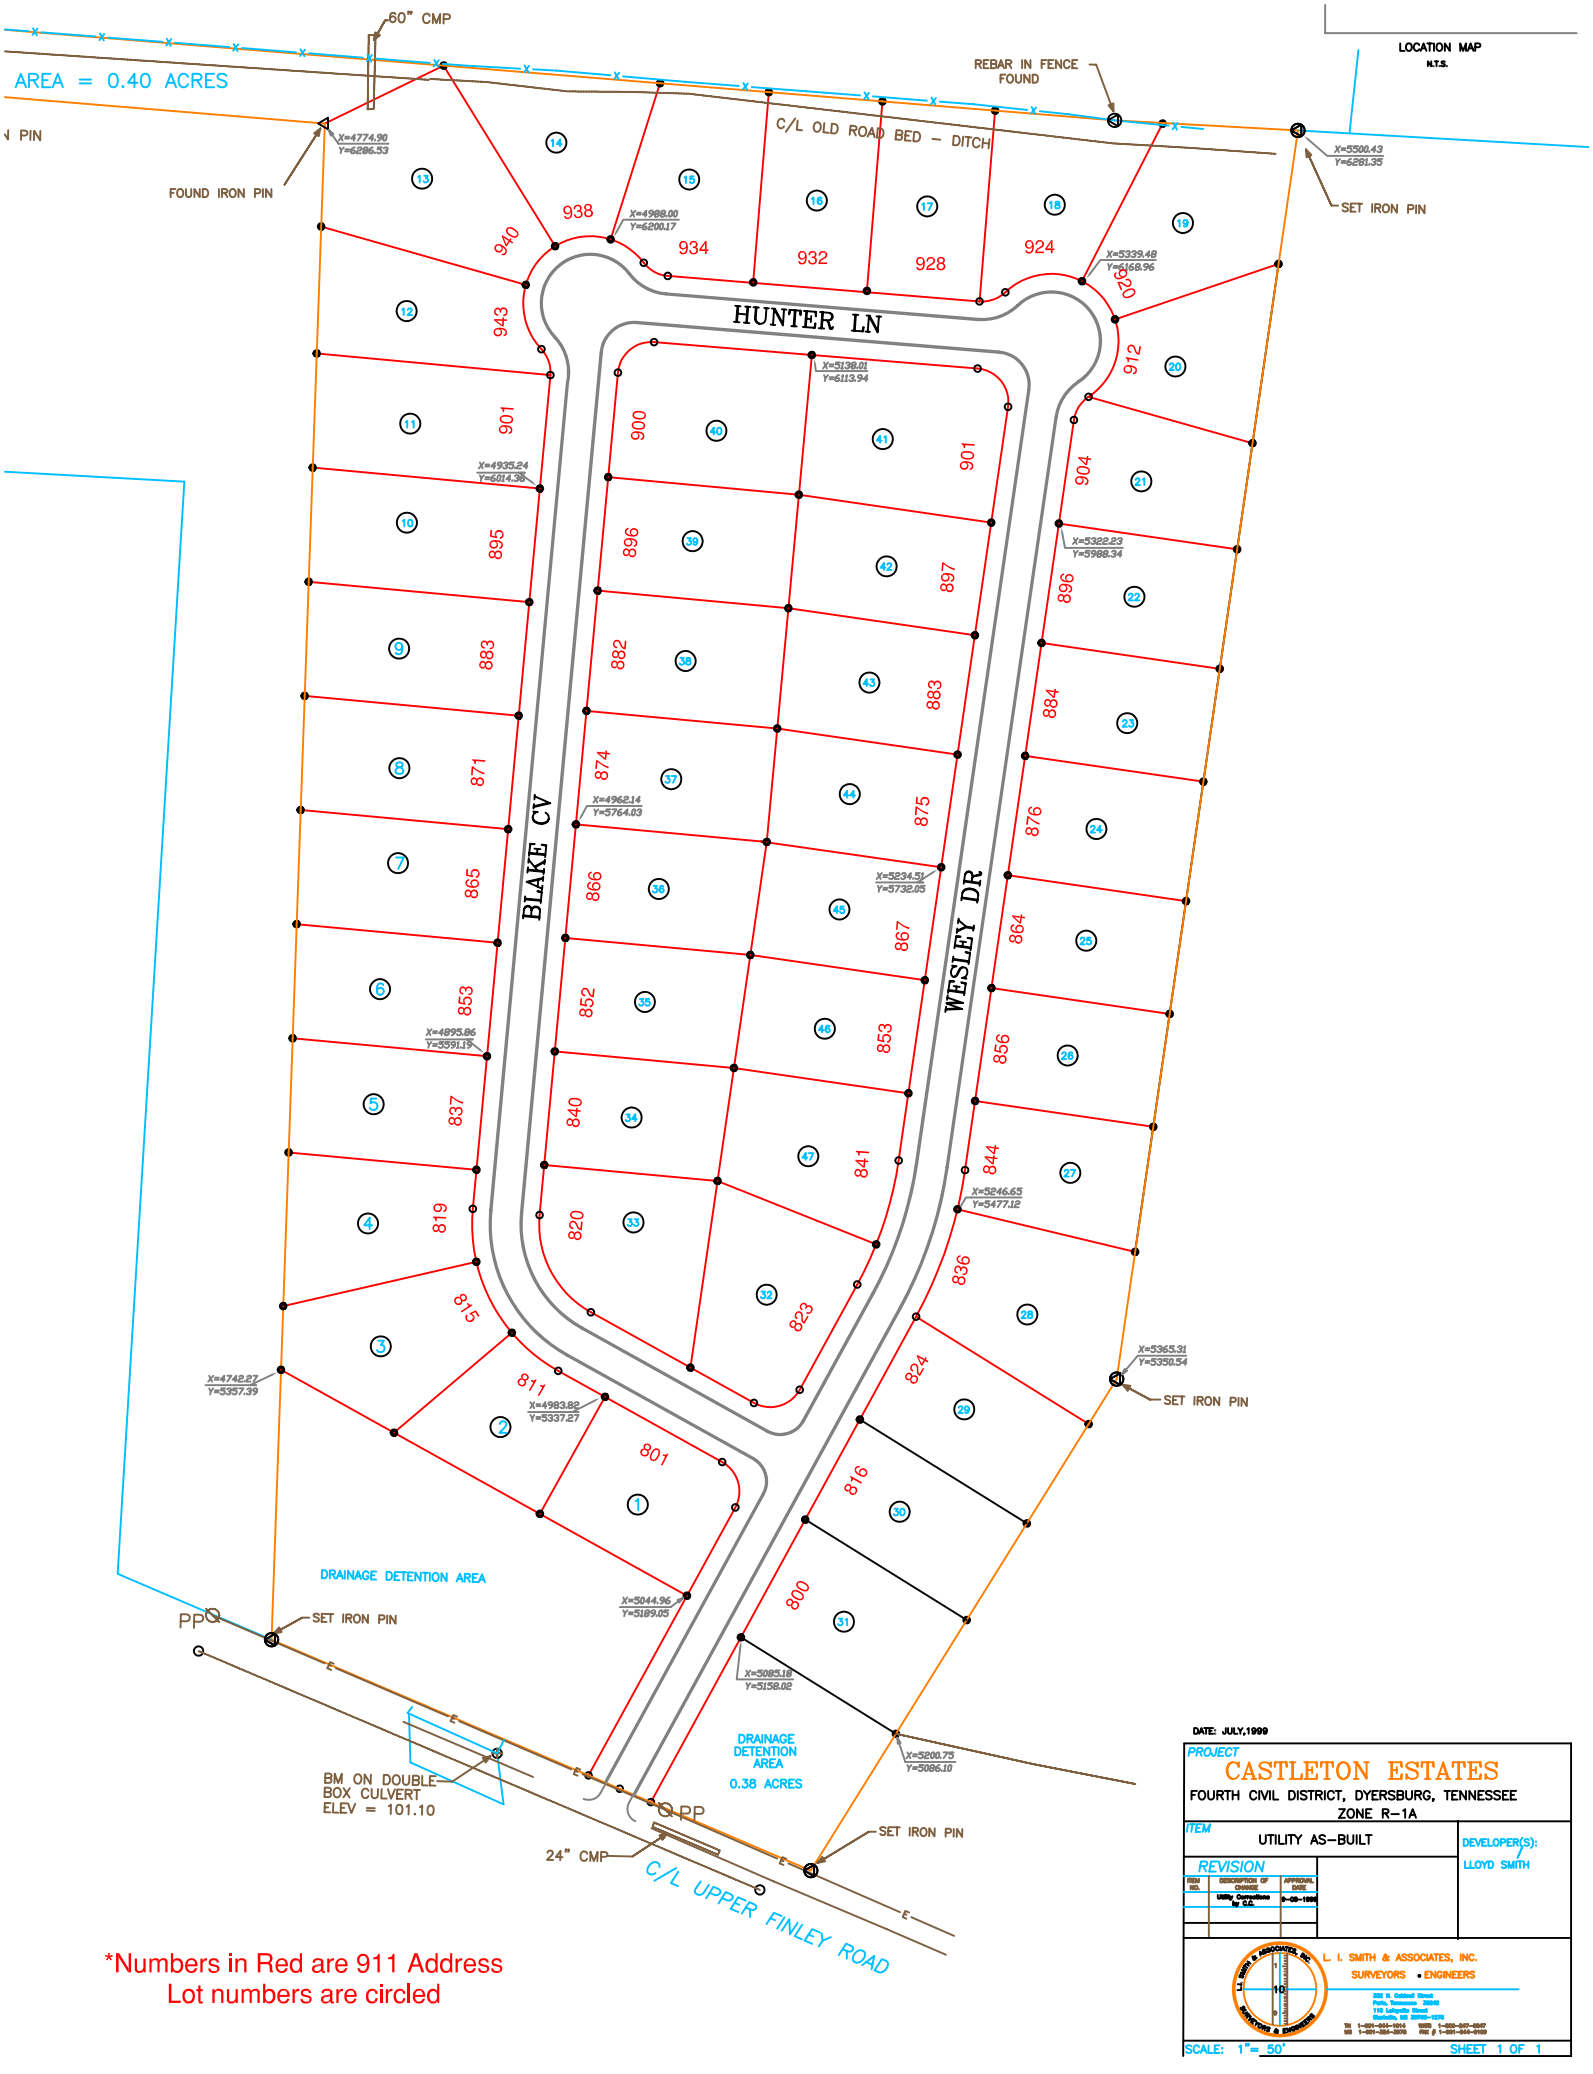

*Numbers in Red are 911 Address
Lot numbers are circled

DATE: JULY,1999

PROJECT
CASTLETON ESTATES
FOURTH CIVIL DISTRICT, DYERSBURG, TENNESSEE
ZONE R-1A

ITEM
UTILITY AS-BUILT

DEVELOPER(S):
LLOYD SMITH

REVISION

ITEM NO.	DESCRIPTION OF CHANGE	APPROVAL DATE
	Utility Corrections by C.C.	9-28-1999

L. I. SMITH & ASSOCIATES, INC.
SURVEYORS • ENGINEERS
202 N. Cabinet Street
Paris, Tennessee 38242
110 Lafayette Street
Hartsville, MS 38760-1276
TN 1-901-644-1614 WEB 1-800-867-0867
MS 1-901-324-3070 FAX # 1-901-644-0169

SCALE: 1"= 50'
SHEET 1 OF 1